


# Green Gables

2345 East Thomas Road

Suite 201 - 884 RSF

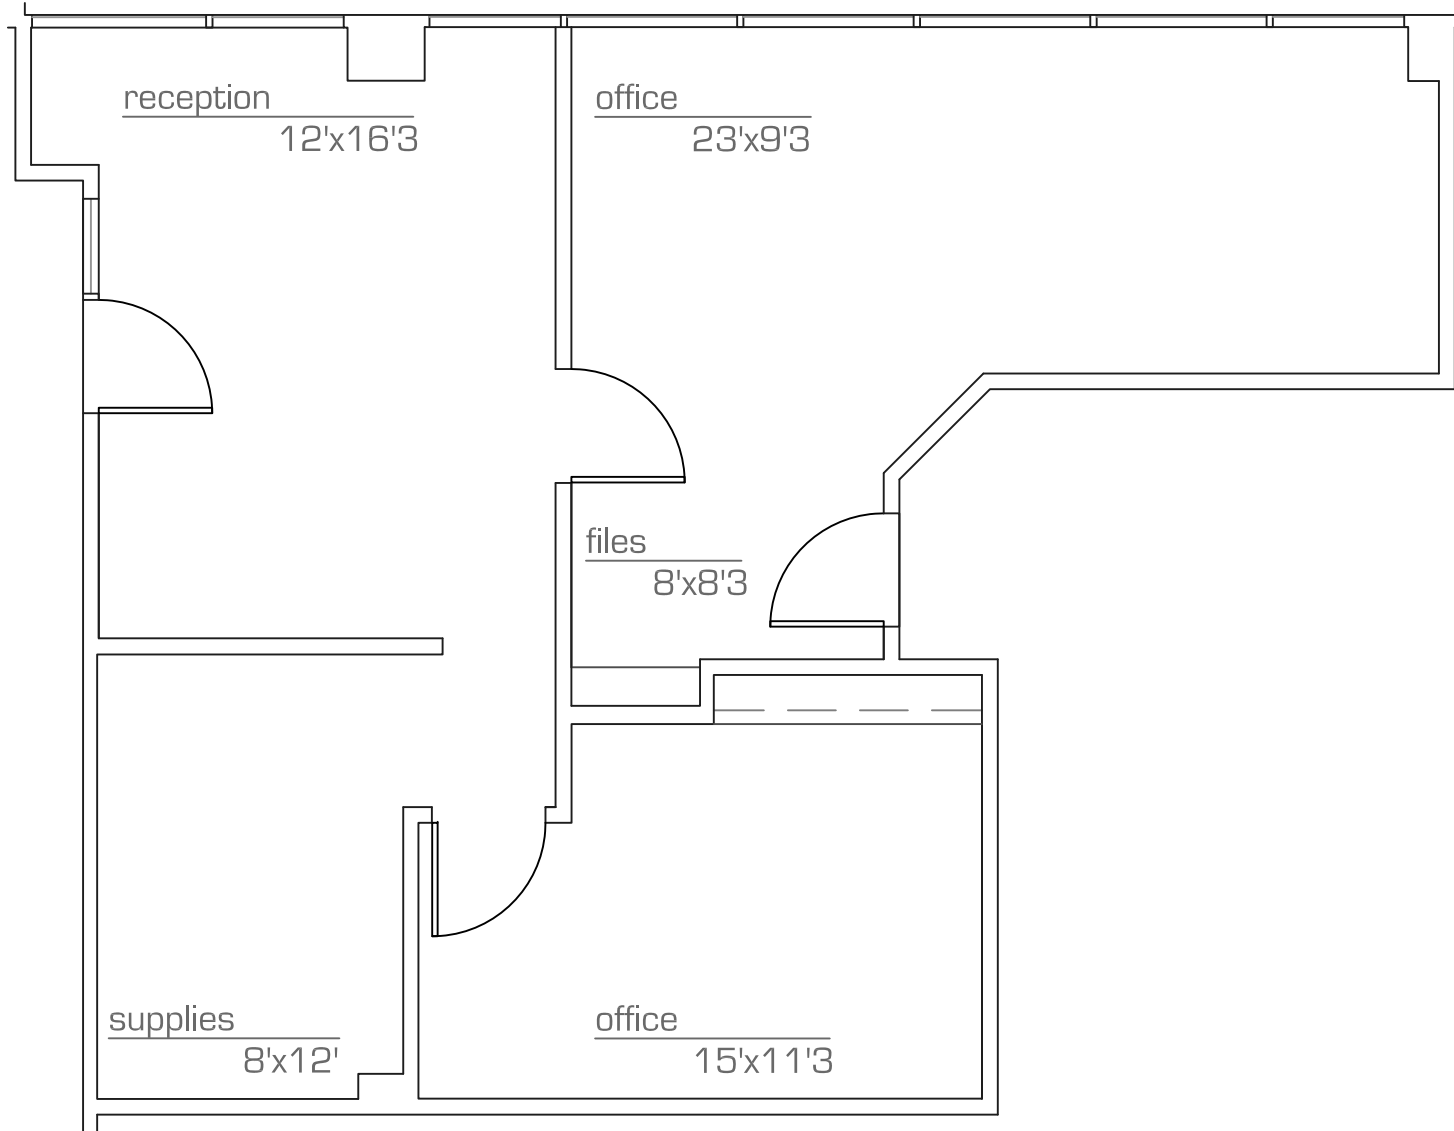

**as-built**

scale: nts

14.July.2009

\*All dimensions are approximate and all information is of general nature.

precision**DIMENSIONS**



as-built . space plans  
architectural design

602.790.6412