


# Green Gables

2345 East Thomas Road  
Suite 275 - 2,138 RSF

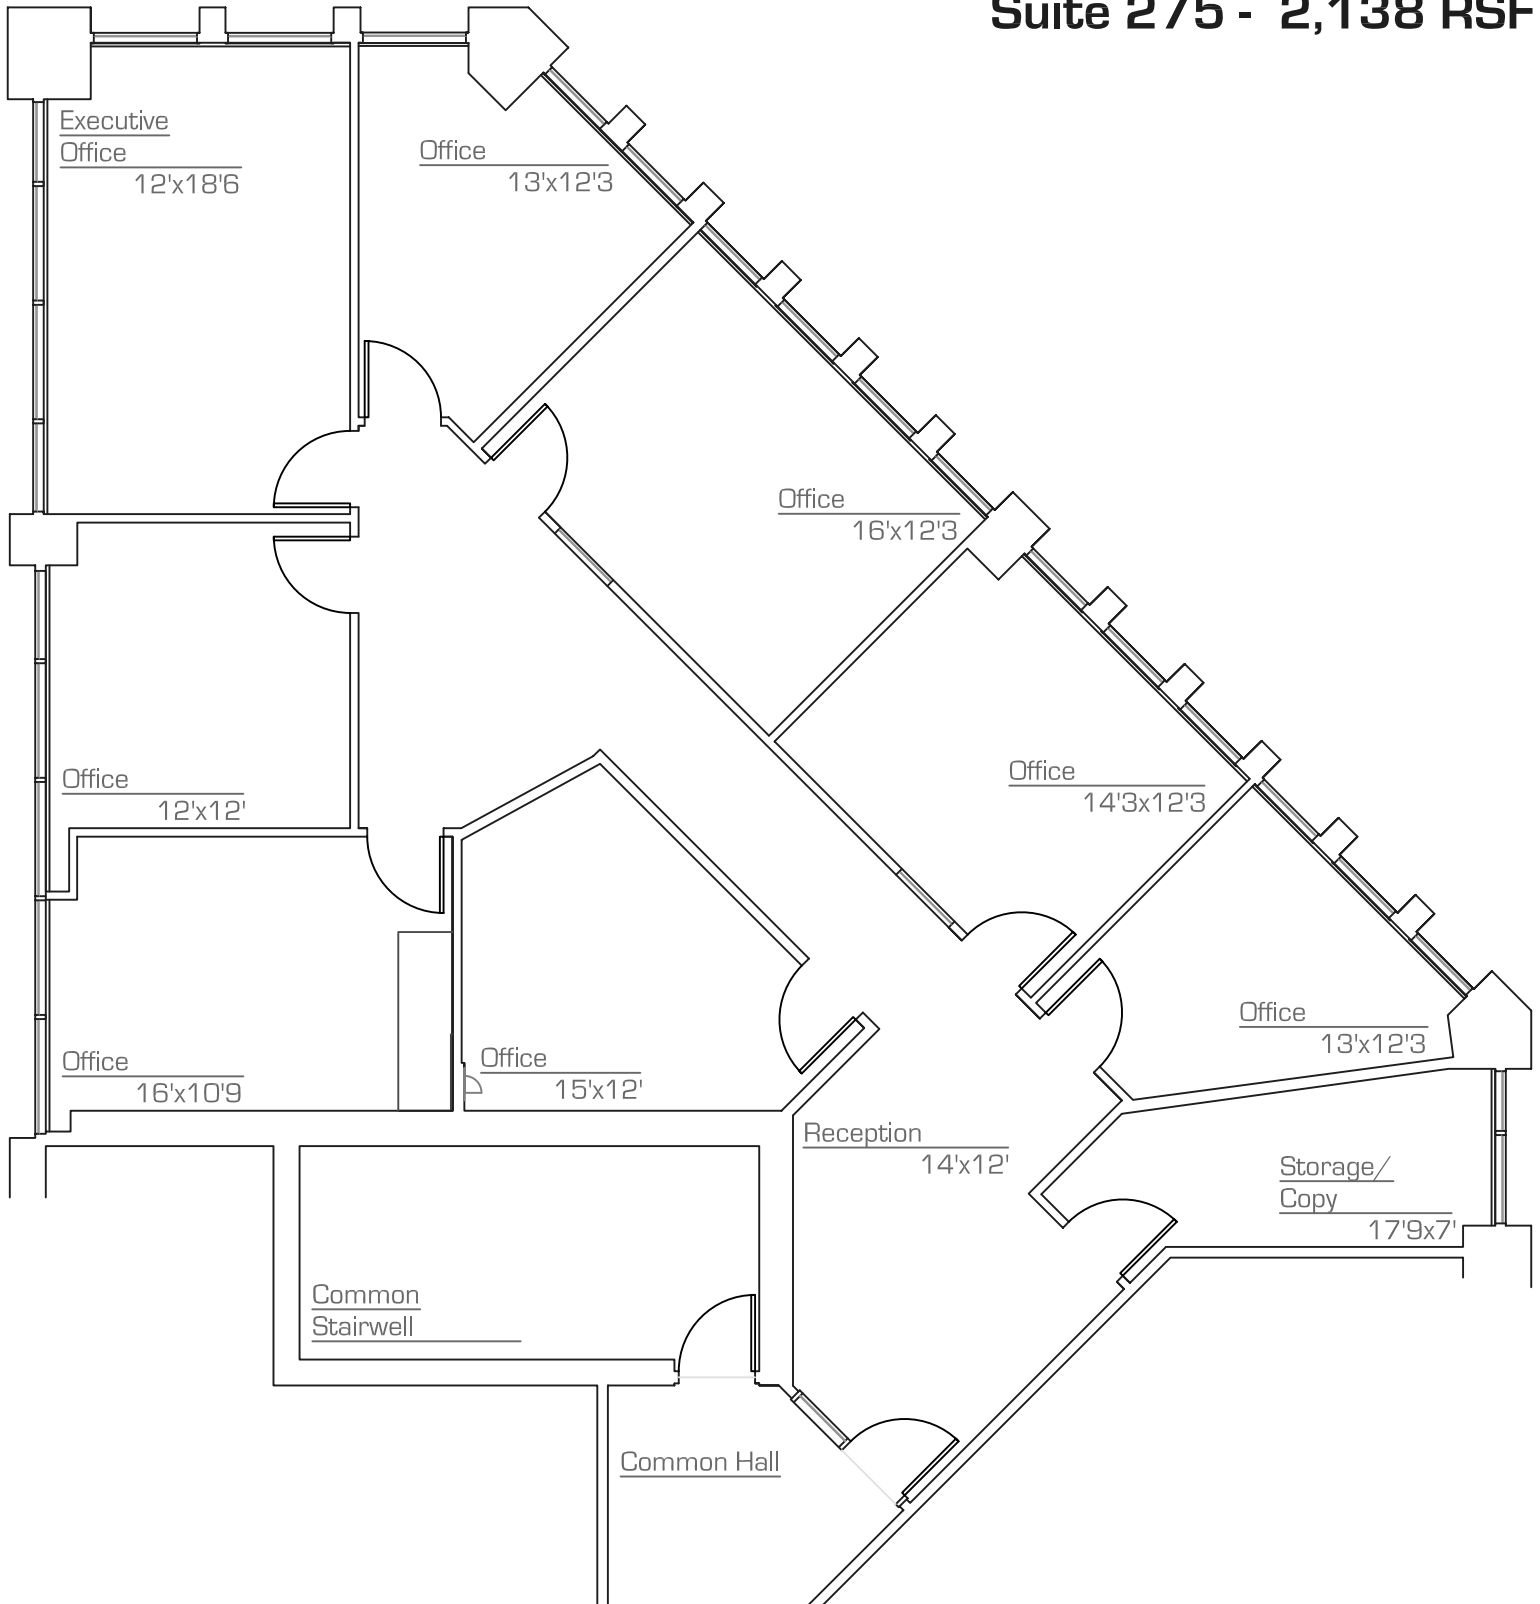


**as-built**

scale: nts  
26.September.2008

\*All dimensions are approximate  
\*All information is of general nature

precision**MEASUREMENTS**

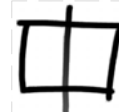

as built . space plans  
architectural design

602.790.6412