


Green Gables Corporate Center

2345 East Thomas Road - Phoenix


Suite 410 - 1,200 RSF

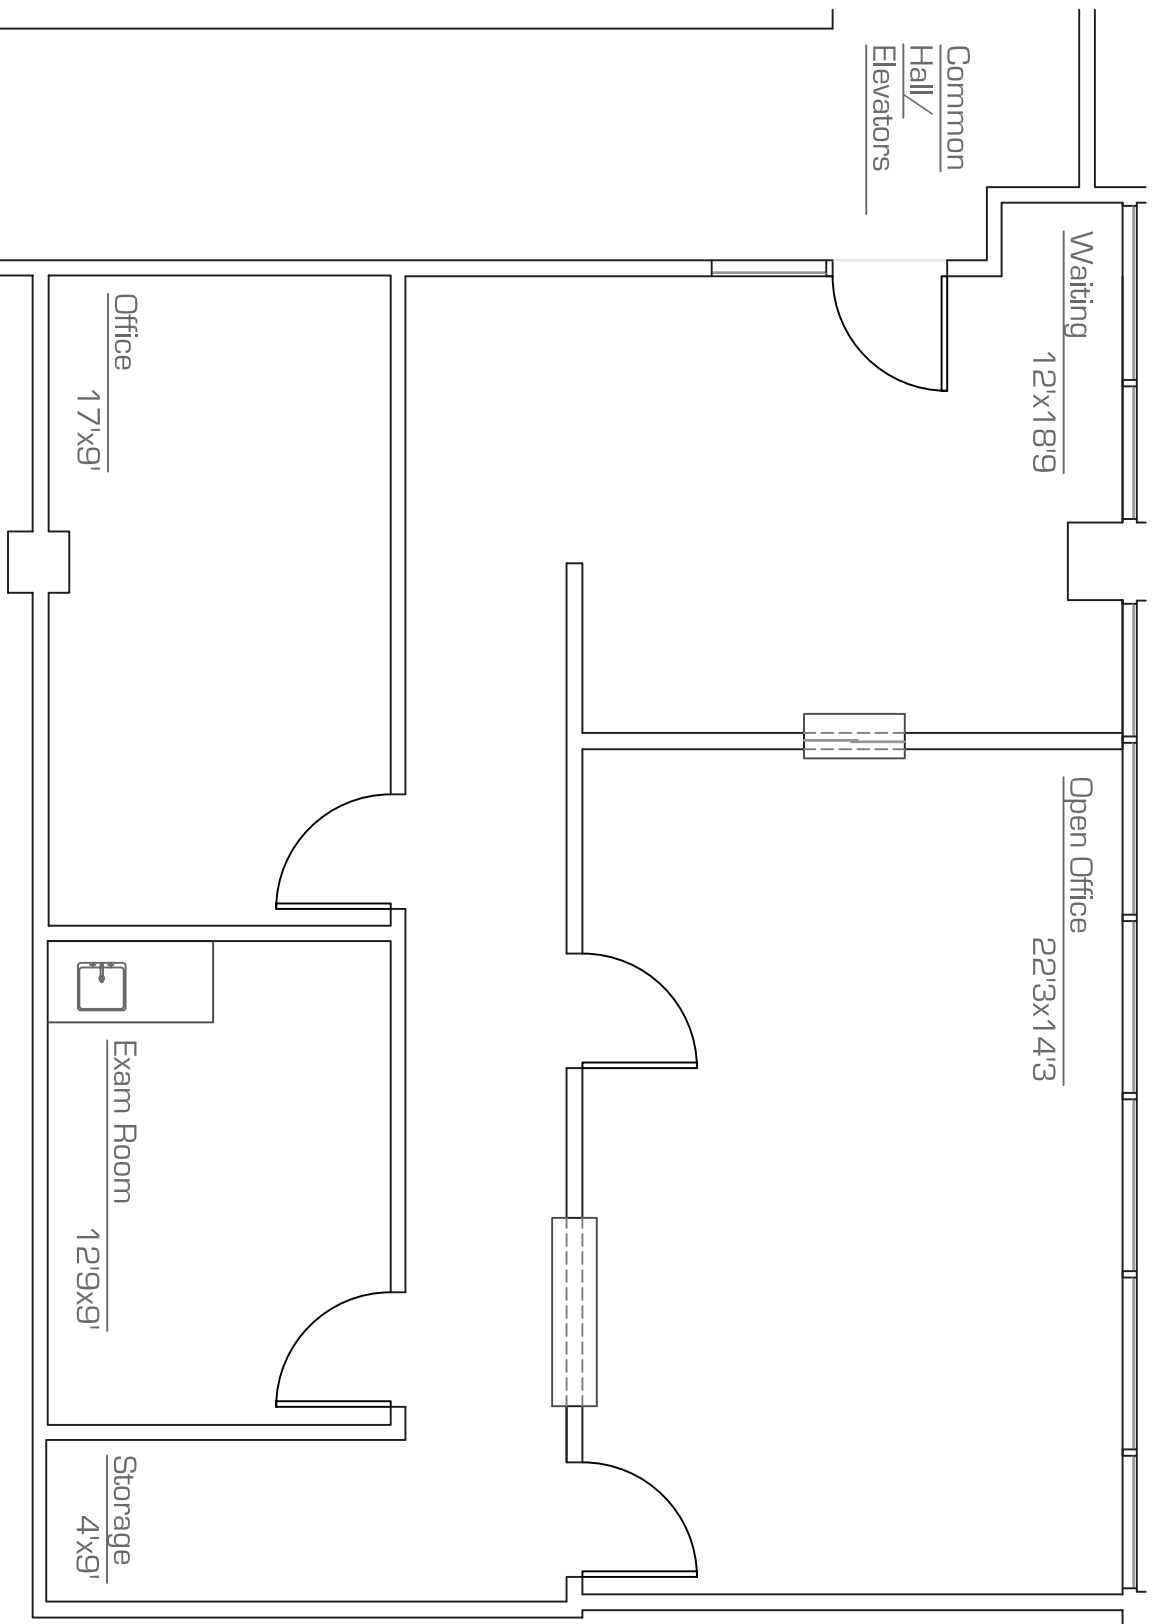

as-built

scale: nts
14.January.2009

* All dimensions are approximate
* All information is of general nature

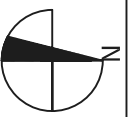

precision **DIMENSIONS**



as built . space plans
architectural design
602.790.6412