
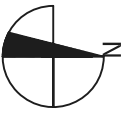


# Green Gables

2345 East Thomas Road . Phoenix  
Suite 420 - 1,330 RSF

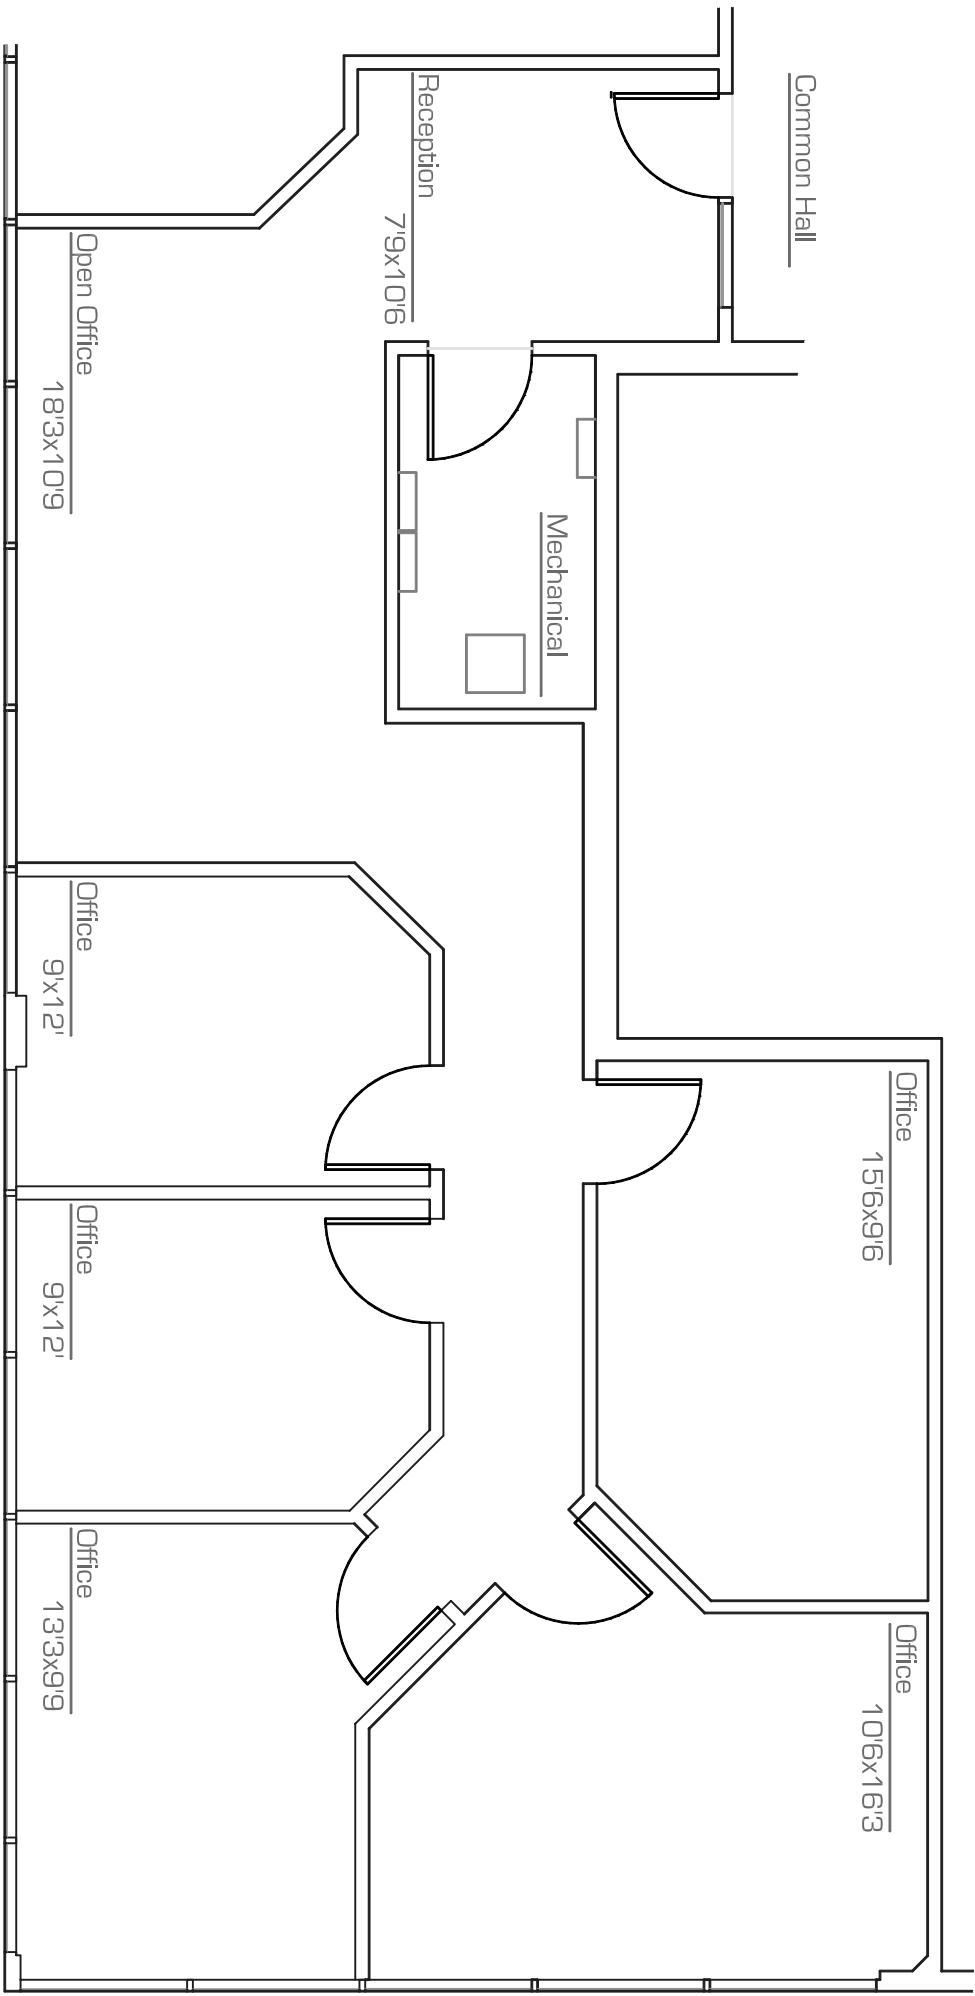

**as-built**

scale: nts

4. September. 2008

\* All dimensions are approximate

\* All information is of general nature

precision **MEASUREMENTS**



as built . space plans  
architectural design

602.790.6412