


Green Gables

2345 East Thomas Road - Phoenix

Suite 462 - 1,384 RSF

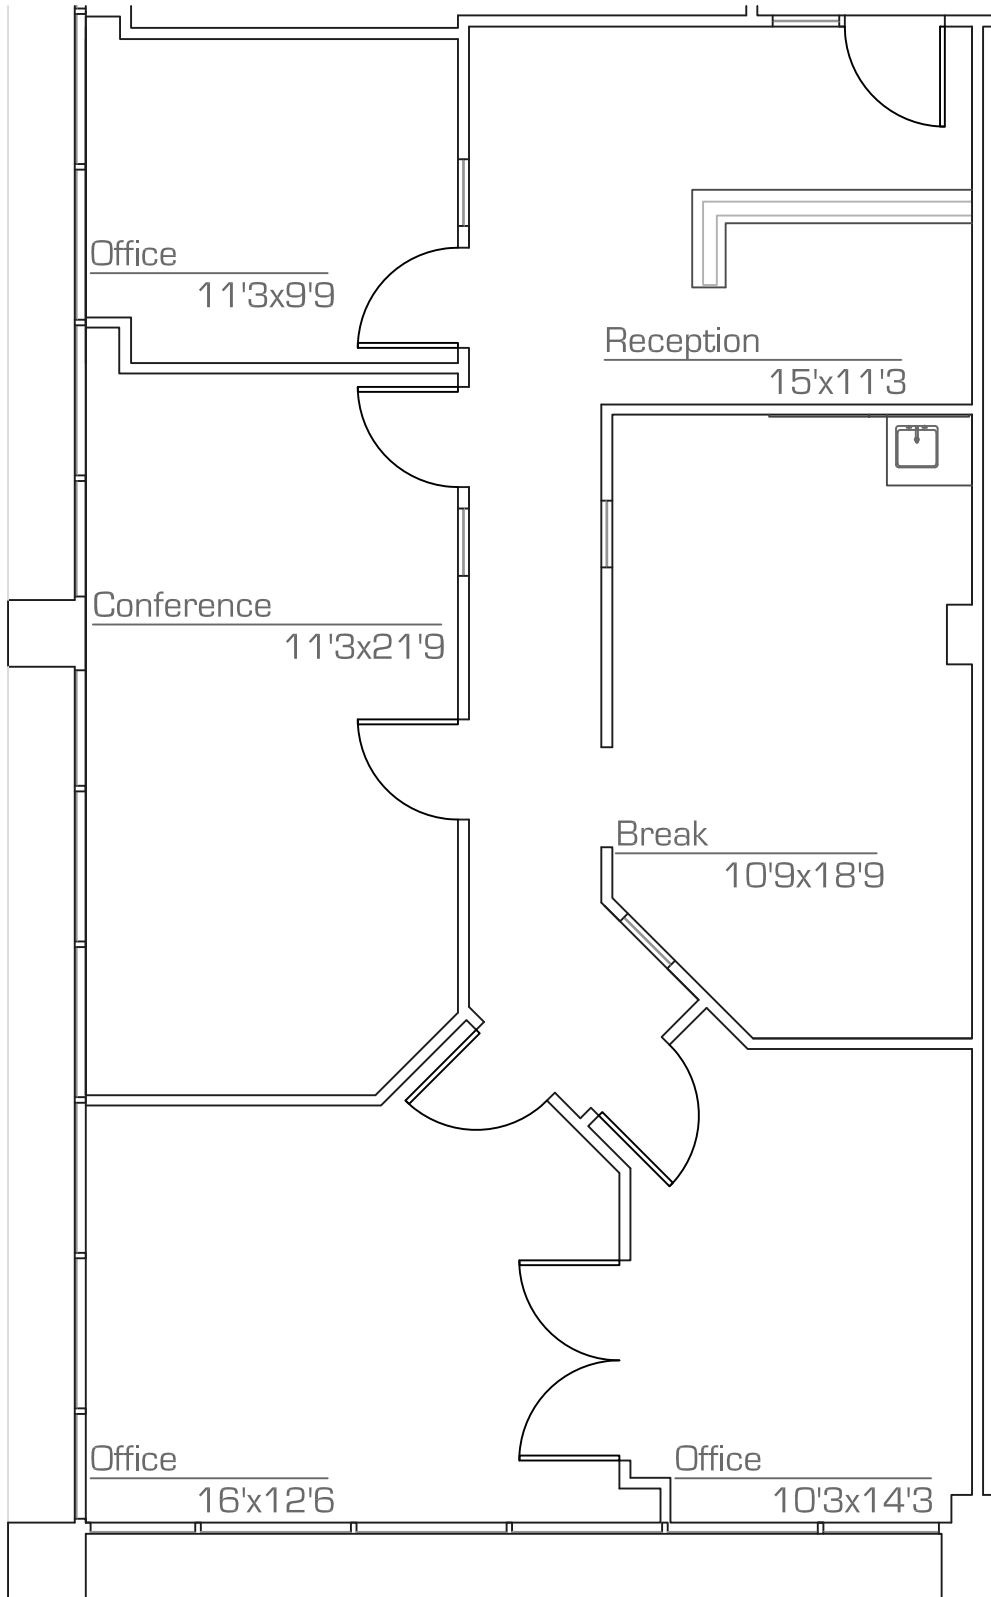

as-built

scale: nts
21.August.2009

*All dimensions are approximate
*All information is of general nature

precision**DIMENSIONS**



as built . space plans
architectural design

602.790.6412