


Lakeview Business Center


2850 South 36th Street . Phoenix

Suite A14 - 3,300 SF

Upper
Level

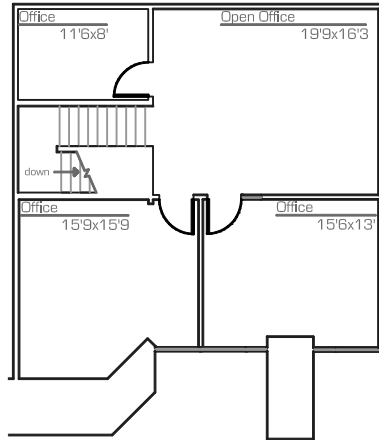

Ground
Level

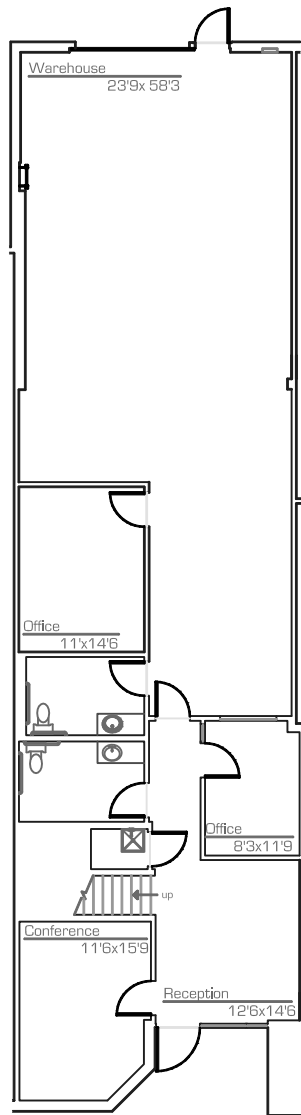

as-built

scale: nts
3.March.2011

*All dimensions are approximate
*All information is of general nature

precision**DIMENSIONS**



as built . space plans
architectural design

602.790.6412