
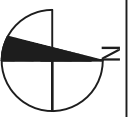


Lakeview Business Center

2840 South 36th Street - Phoenix
E7 - 1,103 RSF

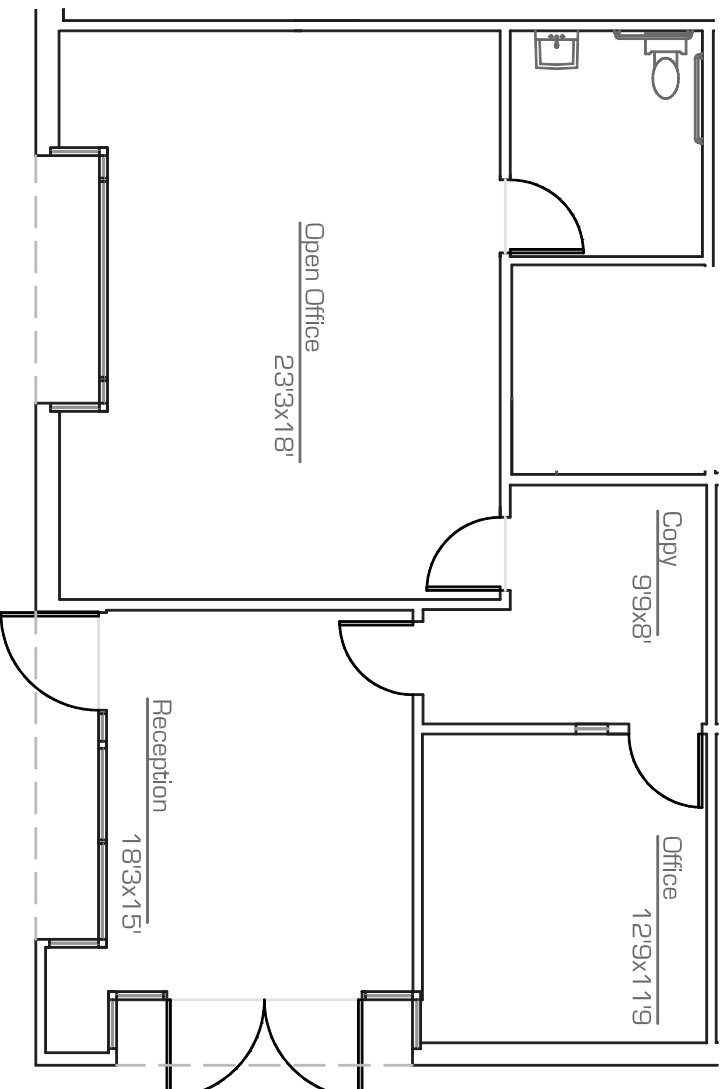

as-built

scale: nts

19.May.2010

* All dimensions are approximate
* All information is of general nature

precision **DIMENSIONS**



as built . space plans
architectural design

602.790.6412