


Lakeview Business Center

2840 South 36th Street . Phoenix

Suite E3 - 1,334 SF

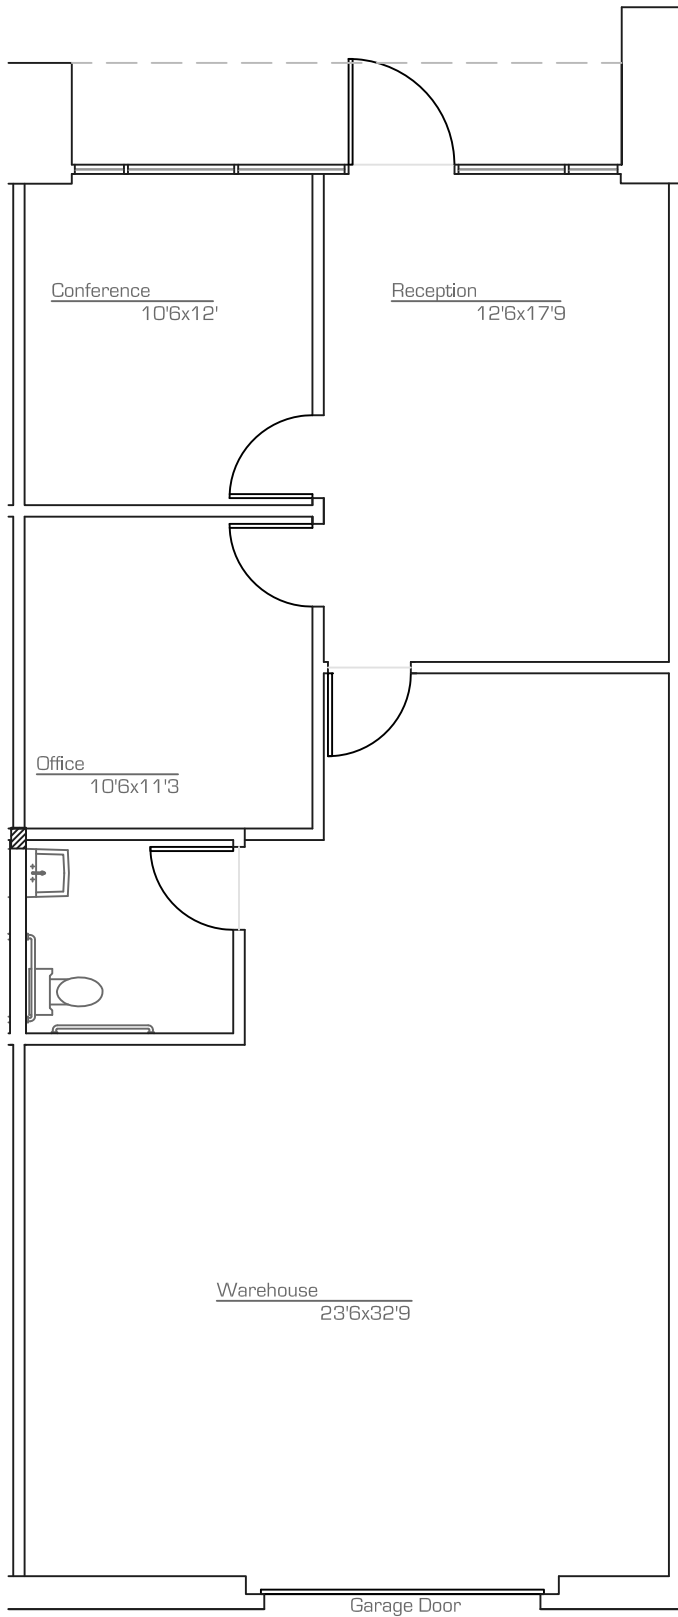

as-built

scale: nts
June.2011



*All dimensions are approximate at $\pm 3"$
*All information is of general nature

precision**DIMENSIONS**



as built . space plans
architectural design

602.790.6412